

Drawings and Specifications are the property of the Architect whether the project for which they are prepared is executed or not. Reproductions shall not be made without the Architect's express written permission.

Revisions

 31 OCTOBER 2024
PLAN REVIEW







Job Number





Issue	
①	22 APRIL 2024 VARIANCE APPLICATION
②	20 MAY 2024 VARIANCE APPLICATION COMPLETENESS
③	
④	

Emergency Permit
105 TERRACE AVENUE
Colinas, CA 94924

APN 193 172 18
Latitude 37.902
Longitude -122.691

Scale: 1/4" = 1'-0"

2.1

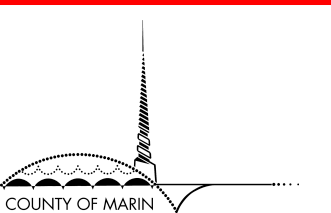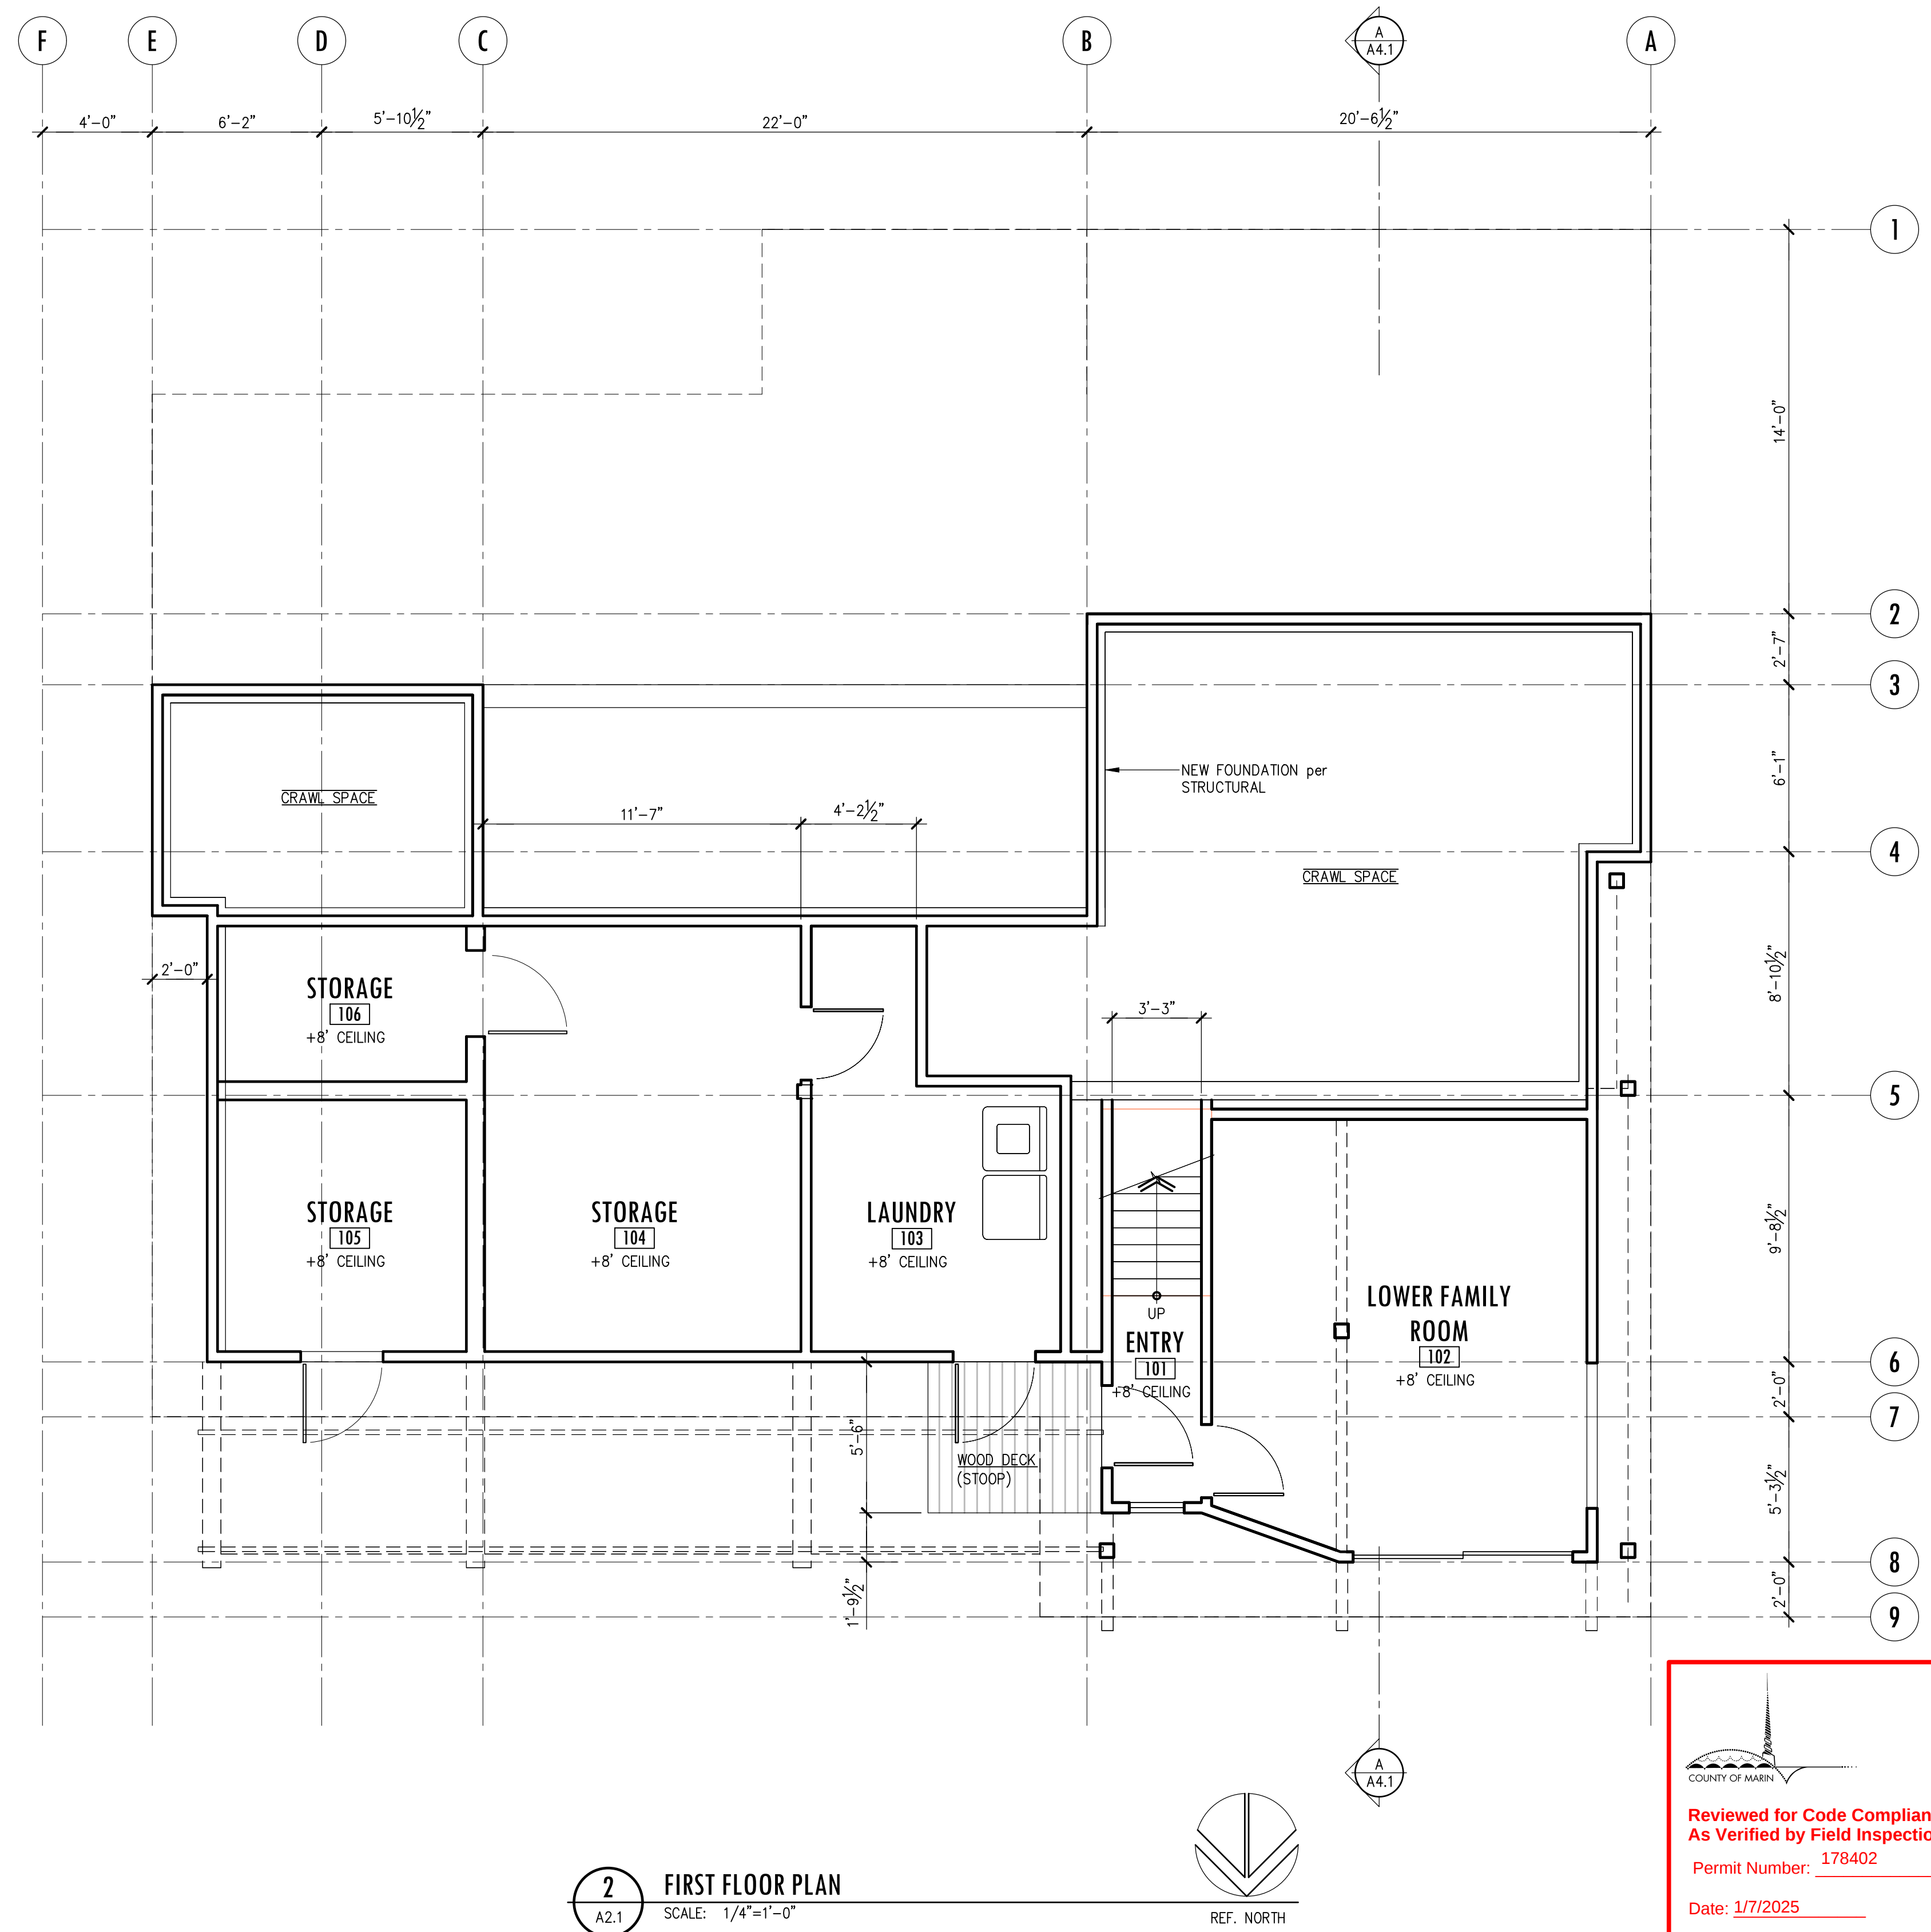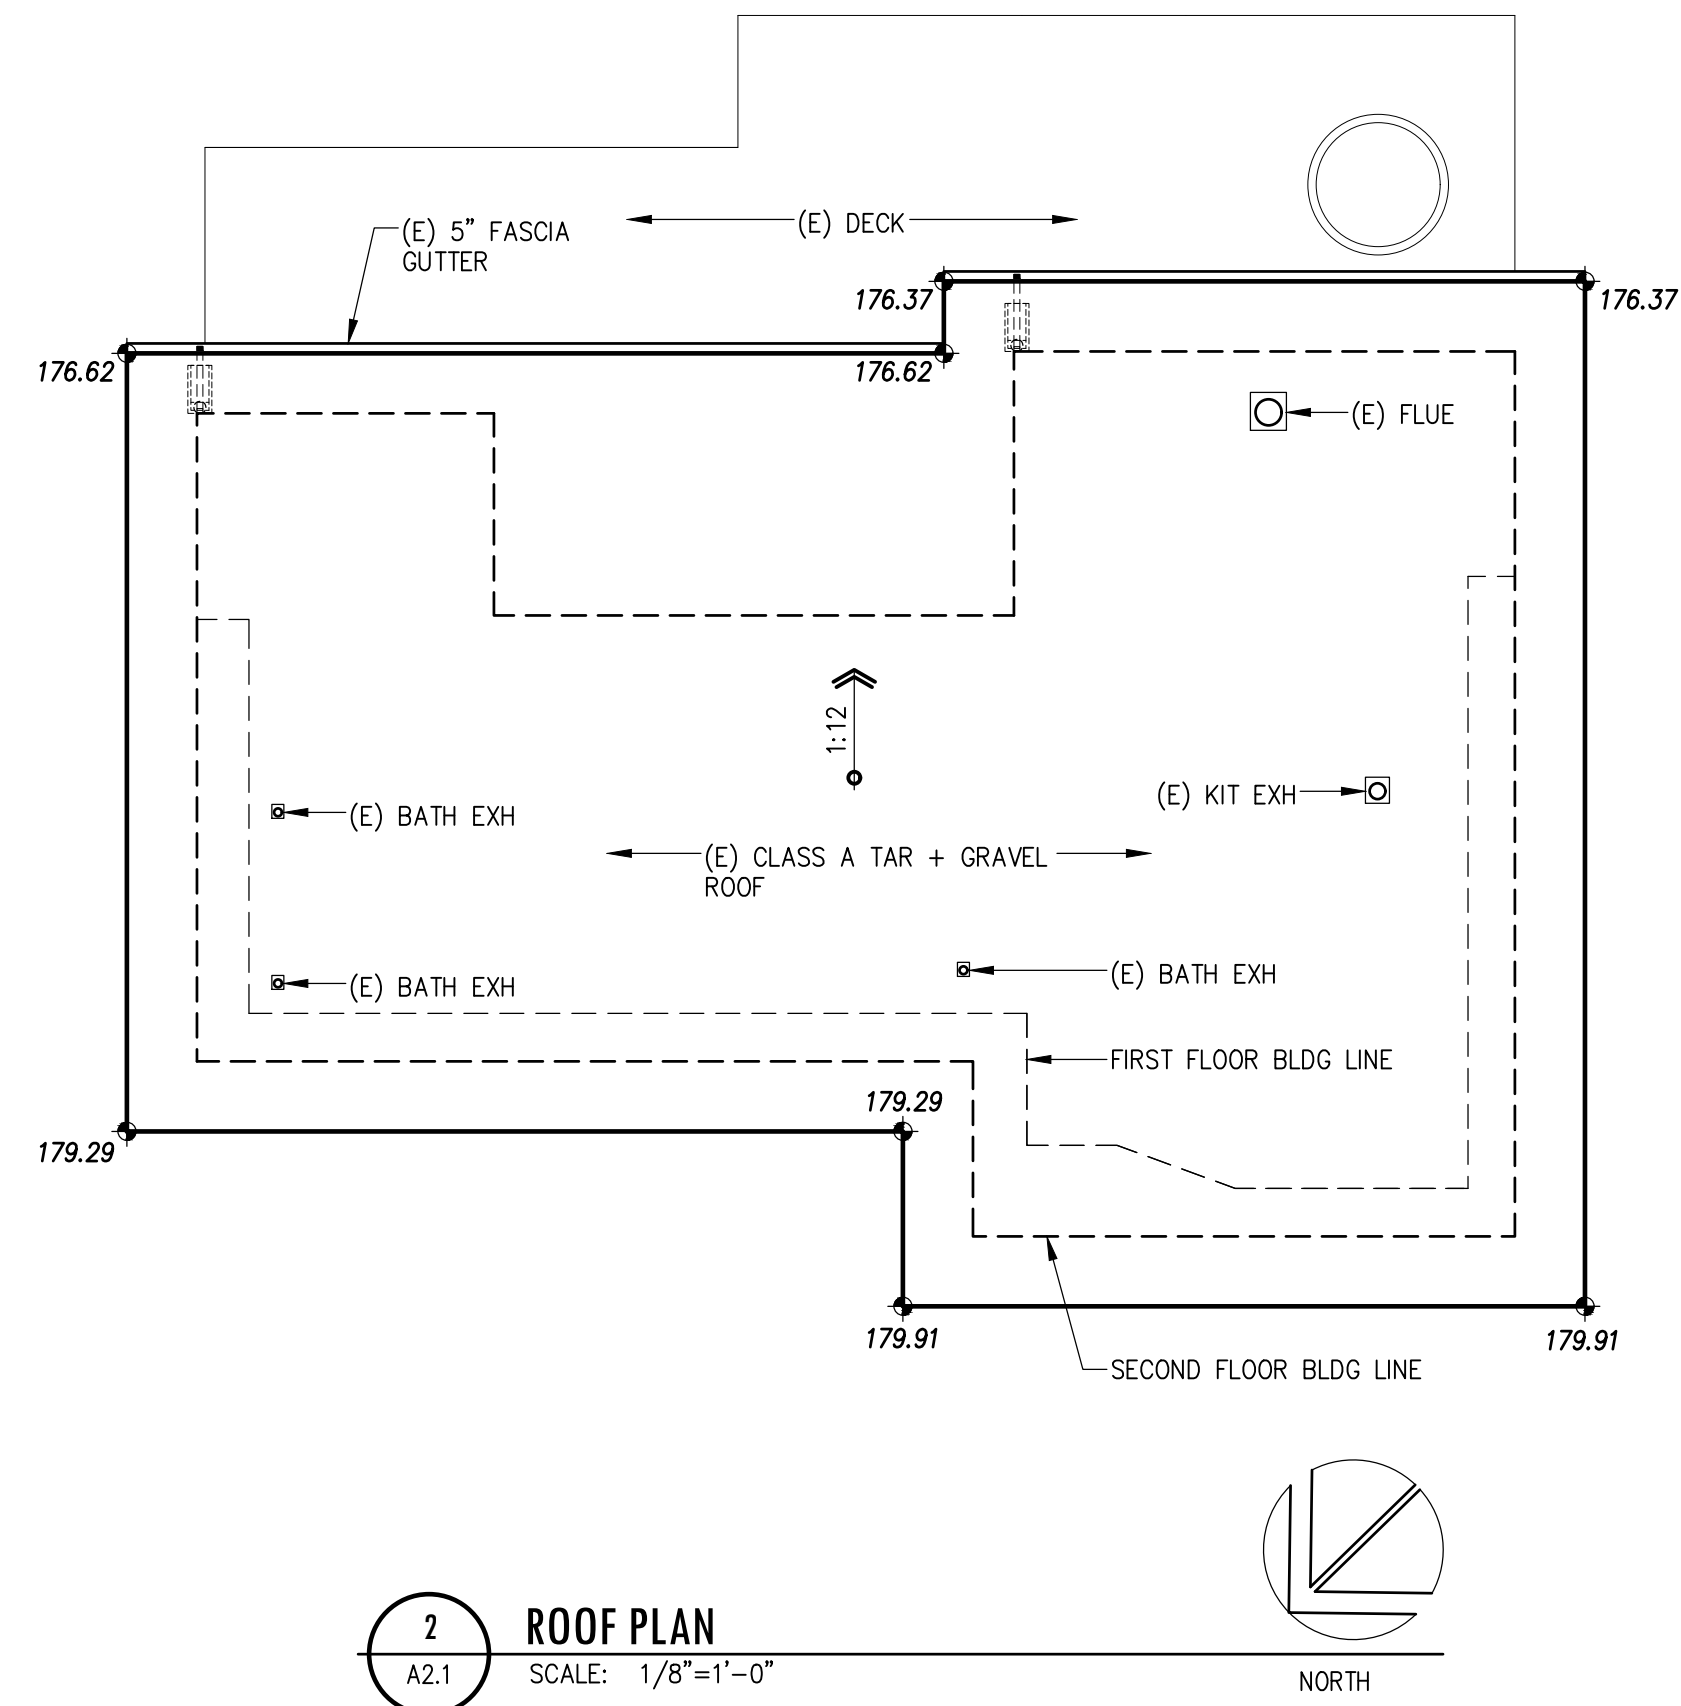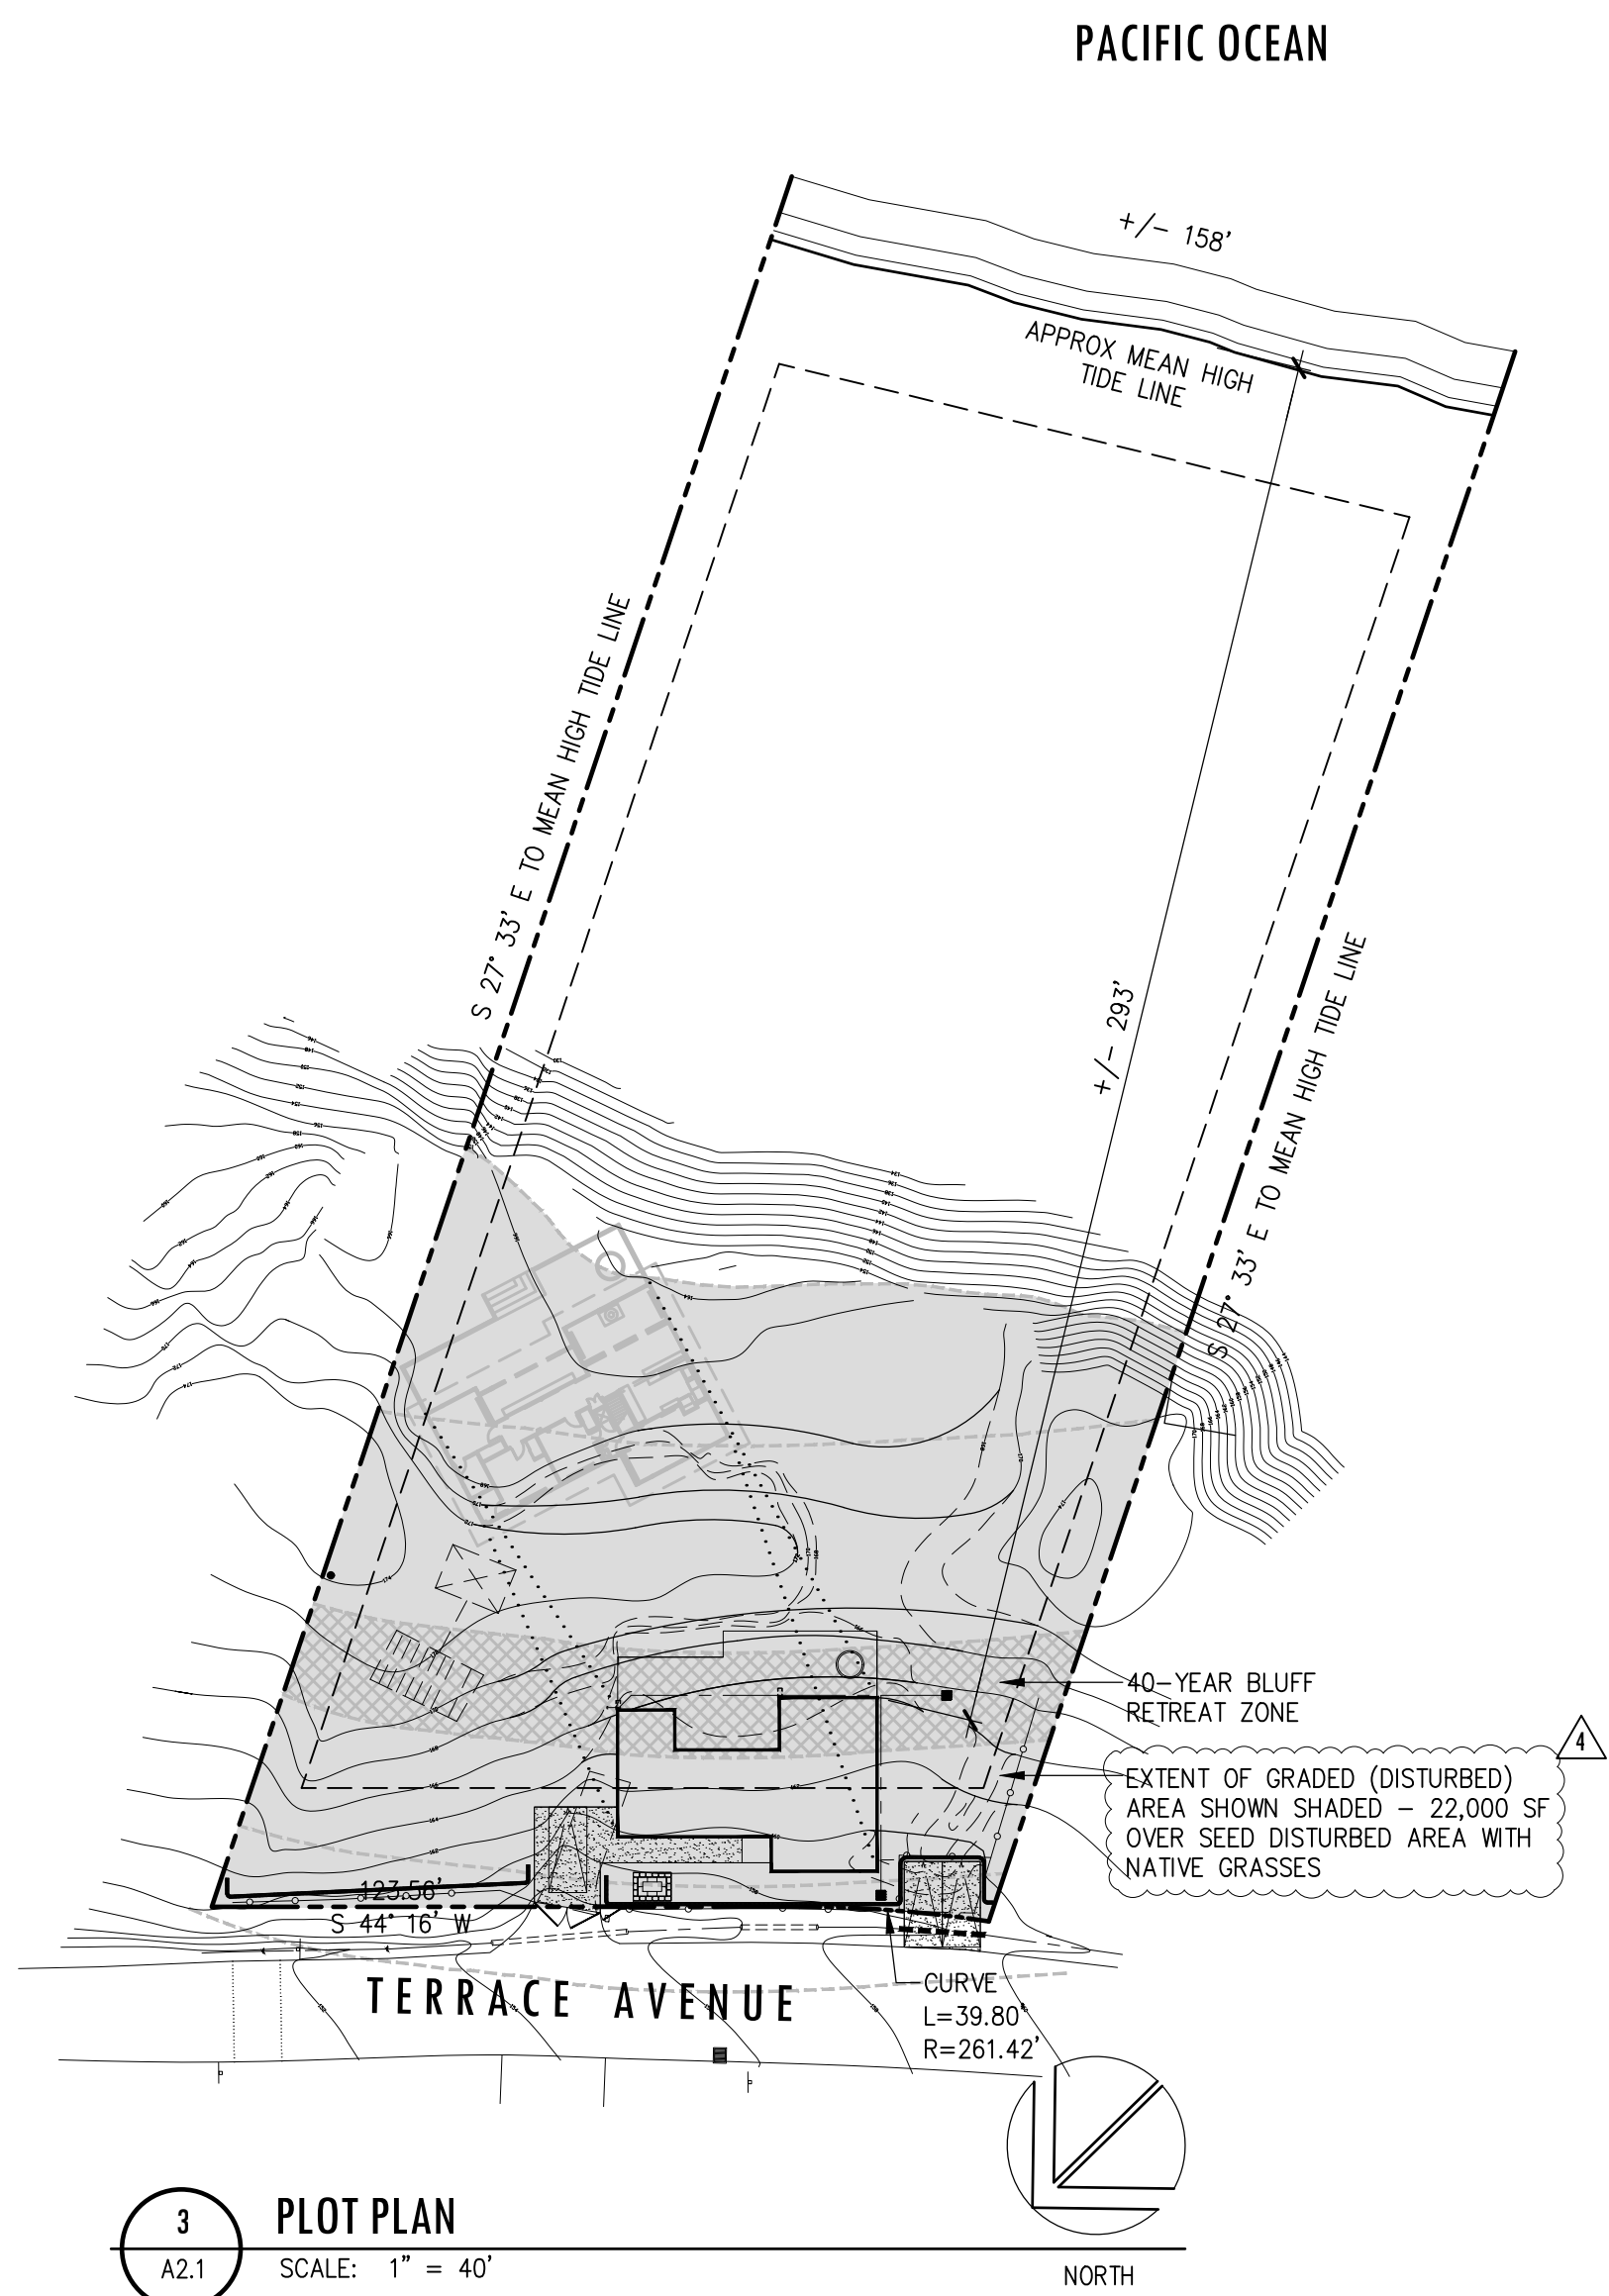

**Reviewed for Code Compliance
As Verified by Field Inspection**

Permit Number: 178402

Date: 1/7/2025